


BASEMENT

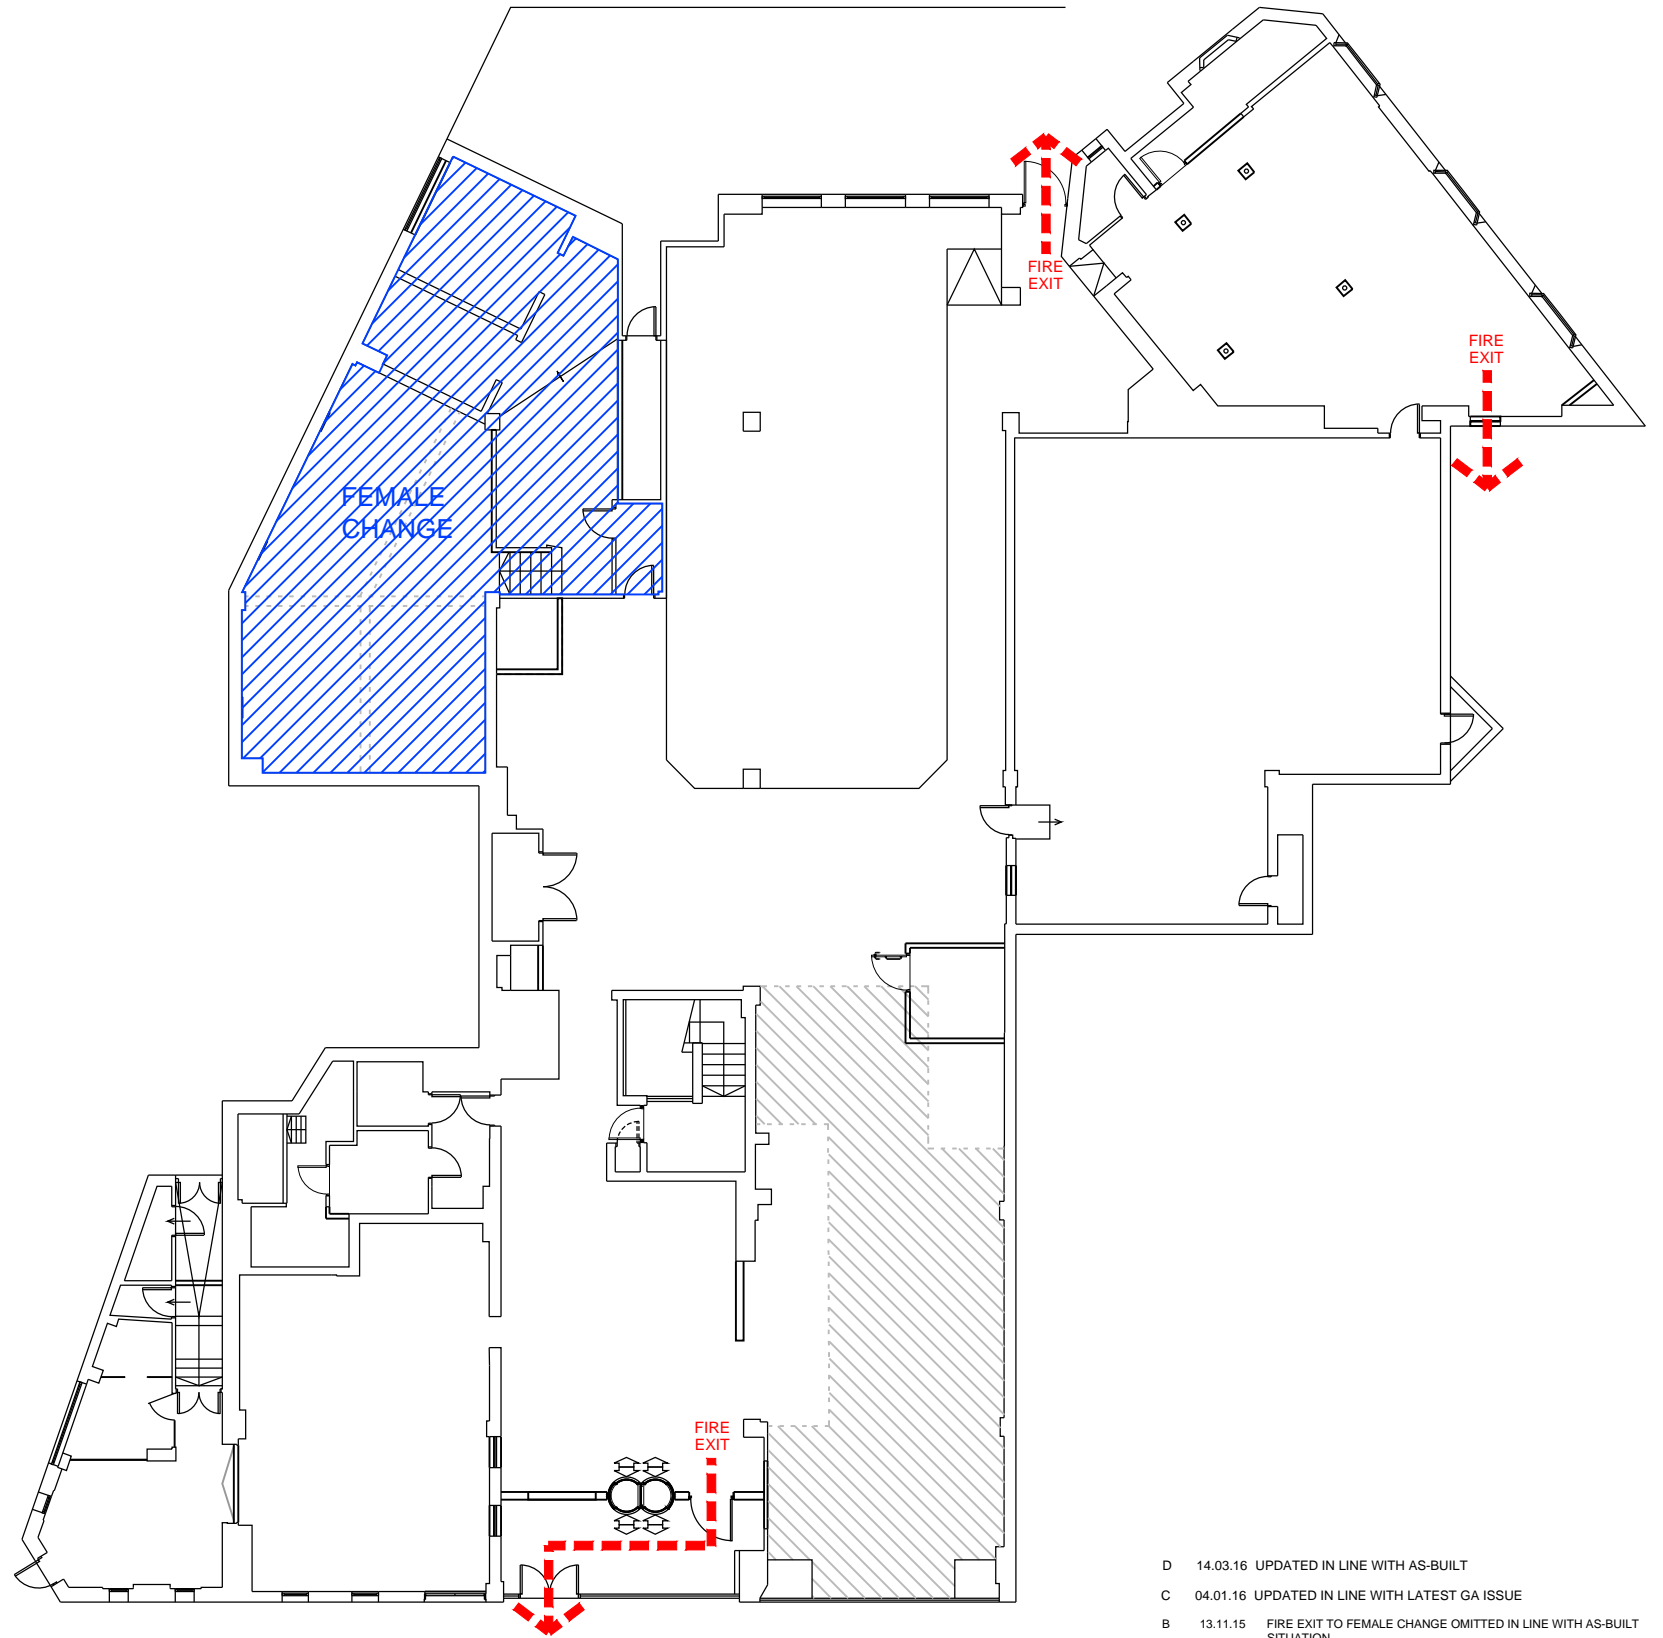

GROUND FLOOR

REV	DATE	DESCRIPTION	DRN	CHK
D	14.03.16	UPDATED IN LINE WITH AS-BUILT	AP	LM
C	04.01.16	UPDATED IN LINE WITH LATEST GA ISSUE	TR	LM
B	13.11.15	FIRE EXIT TO FEMALE CHANGE OMITTED IN LINE WITH AS-BUILT SITUATION	JW	LM
A	08.10.15	UPDATED IN LINE WITH LATEST GA ISSUE	AP	LM

MICHAEL HYDE AND ASSOCIATES LIMITED
chartered architects



MANCHESTER ■ SHEFFIELD □
 51 BARTON ARCADE DEANSGATE MANCHESTER M3 2BJ
 TEL 0161 834 1018 FAX 0161 834 4798
 Manchester@MHA architects.com

ABBKEY HOUSE 11 LEOPOLD STREET SHEFFIELD S1 2GY
 TEL 0114 2727123 FAX 0114 2753043
 Sheffield@MHA architects.com

PROJECT TITLE PURE GYM LTD PROJECT LONDON, SYDENHAM		
DRAWING TITLE FIRE ESCAPE PLAN BASEMENT AND GROUND FLOOR		
DRAWN / CHECKED AP/LM	DATE SEP 15	SCALE 1:200 @ A3
JOB No 1PL28	DRAWING 2-600	REVISIONS D